


THIS SPPOOL MARKUP DRAWING IS GENERATED FROM ENGINEERING PCF & REFERRING APPROVED ENGG ISOMETRICS. ENGINEERING ISOMETRICS TO BE REFERRED FOR REVISION APPROVAL INFORMATION & IN CASE OF ANY DISCREPANCY DATA GIVEN IN ENGINEERING ISOMETRIC SHALL GOVERN

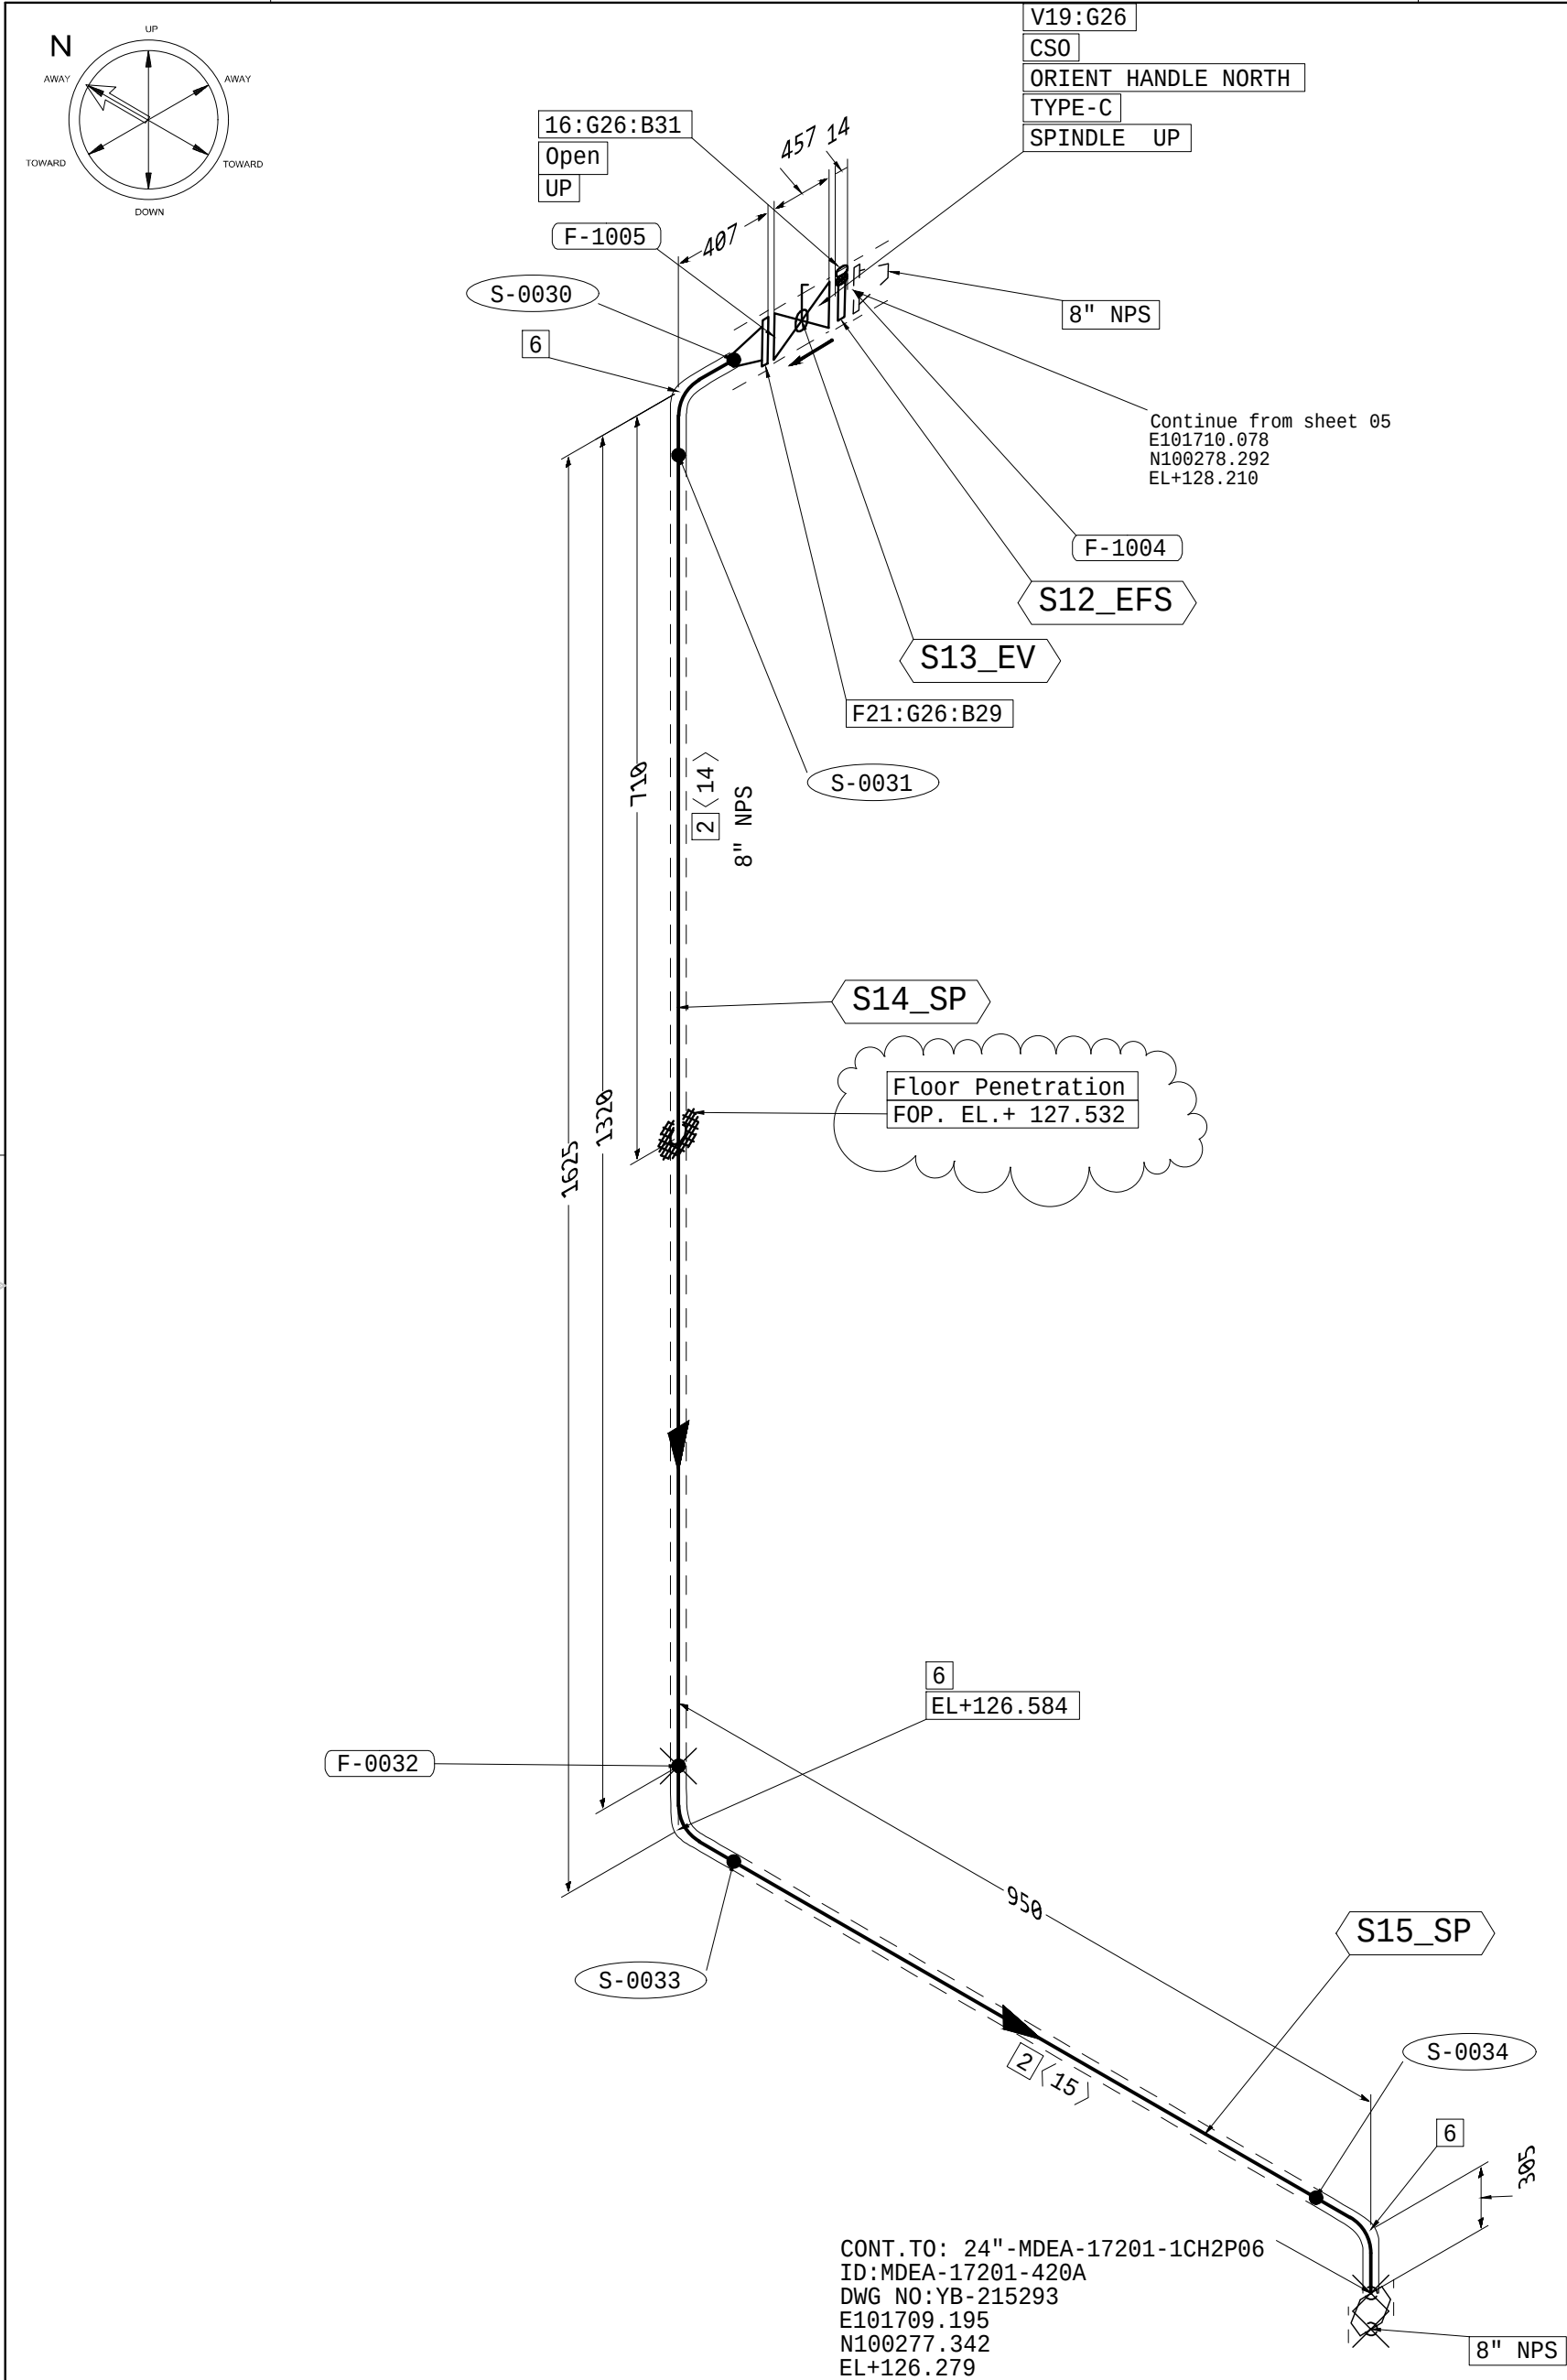

NOTES CONT. :

91. FOR SOUR SERVICE PWHT IS MANDATORY FOR 1. DOUBLE SIDED WELDING, 2. INTERNAL WELD REPAIR 3. INTERNAL WELD BUILD UP FOR DISSIMILAR THICKNESS JOINTS TO OVERCOME MISALIGNMENT.

PWHT	CHEMICAL CLEANING	PIPING MATERIAL CLASS	DESIGN		OPERATING		TEST PRESS. (PSIG)	TEST MEDIUM	RADIOGRAPHY %		INSULATION		TRACING	PAINTING	STRESS SYS NO.	LINE ID
			TEMP. (DEG. F)	PRESS. (PSIG)	TEMP. (DEG.F)	PRESS. (PSIG)			SHOP	FIELD	THK. (MM)	TYPE				
Y	NOTE-8	1CH2P06	190	170	140	65	428	WATER	10	10	25	HC	NA	APCS-2A	867-GPT4-171	MDEA-17358-420A

MATERIALS

PT No.	DESCRIPTION	NPD(IN)	ITEM CODE	QTY
PIPES				
2	PIPE SMLS 8" A106-B SOUR STD BE B36.10M	8	PPS2AERT08ZZABUAIA	1.355
FITTINGS				
6	ELB 90° SMLS LR 8" A234-WPB SOUR STD BE B16.9	8	PE92AZRT08ZZABUIIQ	3
16	SPCT. BLD FF 8" A516 GR70 NORMALISED SOUR 150# 125 SPEC	8	PLF2RVRT08ZZAAADZ	1
VALVE				
19	TAG NO V11-CB-RS-A3-AB-AA-KQC BALL VAL RB API 6D 8" A218-WCB SS316 TRIM, RTFE SEAT 2/3 PIECE CONST, TRUN MNT, FIRE SAFE RF 150# SOUR, LNG PATN + CS0/CSC, GEAR OPT	8	V11CBRS08AJABAAKQC	1
FLANGES				
21	FLG WNRF 8" A105N SOUR STD, 150# 125 B16.5	8	PFY2ADRT08ZZACPADH	1
GASKET				
26	GSK SPR WND W/CS CENTERING RING + I - SS 8" 4.50 MM THICK SS316L+GRPH FILL SOUR 150# B16.20	8	PGUUB5RT08AIAAAZZC	3
FASTSNERS				
29	BOLT, STUD+2 NUTS A193 GR B7M/ A194 GR 2HM, CERAMIC FLP COAT SOUR B18.2.1/18.2.2 - 120 mm Length	0.75	PH8ASCRTAG00120ZZF	8
31	BOLT, STUD+2 NUTS A193 GR B7M/ A194 GR 2HM, CERAMIC FLP COAT SOUR B18.2.1/18.2.2 - 140 mm Length	0.75	PH8ASCRTAG00140ZZF	8


PIPE CUT LENGTH SUMMARY					
SPL No.	NPD	PC No.	LENGTH	ALLOWANCE	TOTAL LENGTH
S14_SP	8	<14>	1.015	0.000	1.015
S15_SP	8	<15>	0.340	0.000	0.340

SXX_Spool Sequence Number (S01,02, SXX_SP - Fab. Spool
SXX_PP - Fab. P to P Doubling (c-0M+0M)
SXX_SP - Erec. Random Pipe (0M,12M)
SXX_EP - Erec. Part Loose Fittings
SXX_EV - Erec. Flange (F-Loose Flange, FFE-Bolt, FFS-Spectacle)
SXX_EV - Erec. valve
SXX_EPG - Erec. Pipe Plug
SXX_SBF - Small Bore Spool Fab.
SXX_SBE - Small Bore Spool Erec.
SXX_SBD - Small Bore Spool Drain
SXX_SBV - Small Bore Spool Vent
[X] PART NUMBER
<X> PIECE NUMBER
[SXX] SHOP WELD
[FSX] FIELD WELD
[SXX,01] SPOOL NUMBER

ISO For

NOTES :

- ALL COORDINATES AND ELEVATIONS ARE IN 'METER' AND ALL DIMENSIONS ARE IN 'MM'.
- PIPE QUANTITY IS IN METERS AND OTHER QUANTITY IN NUMBERS.
- FOR STANDARD SUPPORT, REFER DOC. NO. "PP-866-ST-0001".
- IN CASE OF ANY DISCREPANCY FOR LINE CONDITIONS, LINE DATA GIVEN IN LINE LIST SHALL GOVERN
- FOR SMALL BORE LINES, DIMENSION & ROUTING SHALL BE FIELD ADJUSTED.
- THE SPECIFIED THEORETICAL LOCATION OF EQUIPMENT NOZZLES, SUPPORTING STRUCTURE SHALL BE VERIFIED BEFORE INSTALLING THE PIPING & INTOLERABLE DISCREPANCIES SHALL BE DISCUSSED WITH DESIGN SITE ENGINEER.
- ALL THREADED CONNECTION SHALL BE SEAL WELDED, EXCEPT DRAIN AND VENT PLUG.
- REFER LINE LIST.
- ALL PRESSURE WELDS, OTHER THAN BUTT WELDS, INCLUDING BRANCH CONNECTIONS SUCH AS BRANCH-OLETS, AND BOSS) SHALL BE 100% PT/MT EXAMINED. ALL ATTACHMENT WELDS ON PRESSURIZED COMPONENTS THAT ARE NOT HYDROTESTED AFTER MAKING THE ATTACHMENT WELD SHALL BE 100% PT/MT EXAMINED.

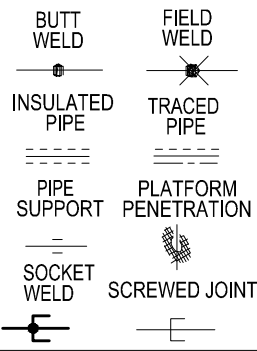

STANDARD DETAIL REFERENCE DRAWINGS

DETAILS HEAVY WELDING BOSS FOR THREADED CONNECTIONS
CONSTRUCTION DETAILS AND DETAILS FOR ISOMETRIC PIPING
INSULATION DETAILS FOR HOT PIPING
INSULATION DETAILS FOR COLD PIPING
INSTALLATION OF JACK SCREWS FOR FLANGED JOINTS

AE-036175
AD-036077
AA-036911
AA-036913
AC-036930

NOTES

- MATERIAL SHOWN WITH A BROKEN LINE AND SPOOLS LISTED IN THE SAUDI ARAMCO FABRICATION LIST ARE NOT TO BE FURNISHED BY THE VENDOR.
- PIPING DETAILS SHALL BE CUT AT ALL POINTS MARKED F.W. (FIELD WELD).
- EACH FABRICATED SECTION SHALL BE CLEARLY MARKED WITH ITS CODE NUMBER.
- UNLESS OTHERWISE NOTED: (A) ALL DIMENSIONS ARE TO FACE OF FLANGES, (B) BOLT HOLES ON FLANGES STRADDLE C. (C) WELDING ELBOWS ARE LONG RADIUS.
- FABRICATION SHALL BE IN ACCORDANCE WITH SAUDI ARAMCO SPECIFICATION 01-SAMSS-10.
- GASKET ALLOWANCE
- PIPING MATERIAL IS

PIPE SIZE	SCHEDULE	SPECIFICATION

5. WELDING STRESS RELIEF - YES ☐ NO ☐ 100% X-RAY ☐ SPOT X-RAY 01-SAMSS-10 ☐
9. TESTING SHOP HYDROSTATIC TEST - YES ☐ NO ☐ THE SHOP HYDROSTATIC TEST SHALL BE CARRIED OUT ON PIECES HAVING ALL ENDS FLANGED, HYDROSTATIC TEST PRESSURE
10. ALL PIPING MATERIAL IS IN ACCORDANCE WITH SAUDI ARAMCO ENGINEERING SPECIFICATION SAESL-105 CLASS . ALL EXCEPTIONS ARE NOTED ON THE ISOMETRIC.
11. INSULATION REQUIRED - YES ☐ NO ☐ INSULATION SHOWN ON DRAWING

SPOOLS TO BE FABRICATED BY VENDOR

NO. PIECES	MARK NO.	SIZE	WEIGHT LBS	NO. PIECES	MARK NO.	SIZE	WEIGHT LBS

SPOOLS TO BE FABRICATED BY SAUDI ARAMCO

NO. PIECES	MARK NO.	SIZE	NO. PIECES	MARK NO.	SIZE

REFERENCE DRAWINGS

PIPING PLAN	YA-212287
P&ID NO.	YA-221177-001
PLOT PLAN KEY PLAN NO.	YA-212083
INDEX FOR PIPING ISO (AG)	PP-867-LI-0003
INDEX FOR PIPING ISO (UG)	PP-867-LI-0004

00A	02-05-25	ISSUED FOR CONSTRUCTION	AC/SN	KY/PD	BSP	HJ
REV	DATE	DESCRIPTION	PREP BY	CHKD BY	APP BY	APP BY

REVISION STATUS

REVISION VALIDATION

THIS REVISION NO. 00A IS COVERED FOR ALL APPROVAL AND CERTIFICATION REQUIREMENTS, PER SAEP-33A. UNDER DRAWING COMPLETION CERTIFICATE NO:

10-14815-0003-000

DESIGN CERTIFICATION (DESIGN AGENCY)		REVIEW FOR KEY DRAWINGS (SAUDI ARAMCO)		OTHER	
ENGL. DATE	CERTIFIED BY DATE	CONF. AGENCY DATE	OPERATIONS DATE	BY DATE	
REV NO.	DATE	REVISION DESCRIPTION			

JOB ORDER/REV NO.

10-14815-0003

THIS REVISION IS NOT TO BE USED FOR CONSTRUCTION UNLESS CERTIFIED AND DATED

SAUDI ARABIAN OIL COMPANY

ISOM 8" -MDEA-17358-1CH2P06

DRAWING TYPE

MDEA SERVICE

JFGP GAS PROCESSING TRAIN-4

JAFURAH

SAUDI ARABIA

PLANT NO.	INDEX	DRAWING NUMBER	SHT. NO.	REV. NO.
867	L	YB-215336	060f08	00A

SITE REV. NO. 00A

RESTRICTED

SMART

CADD-03

450420

09-05-2025

THIS DRAWING AND THE INFORMATION CONTAINED HEREIN ARE THE SOLE PROPERTY OF SAUDI ARAMCO. NO REPRODUCTION IN FULL, OR IN PART, SHALL BE OBTAINED FROM THIS DRAWING WITHOUT THE WRITTEN CONSENT OF SAUDI ARAMCO.