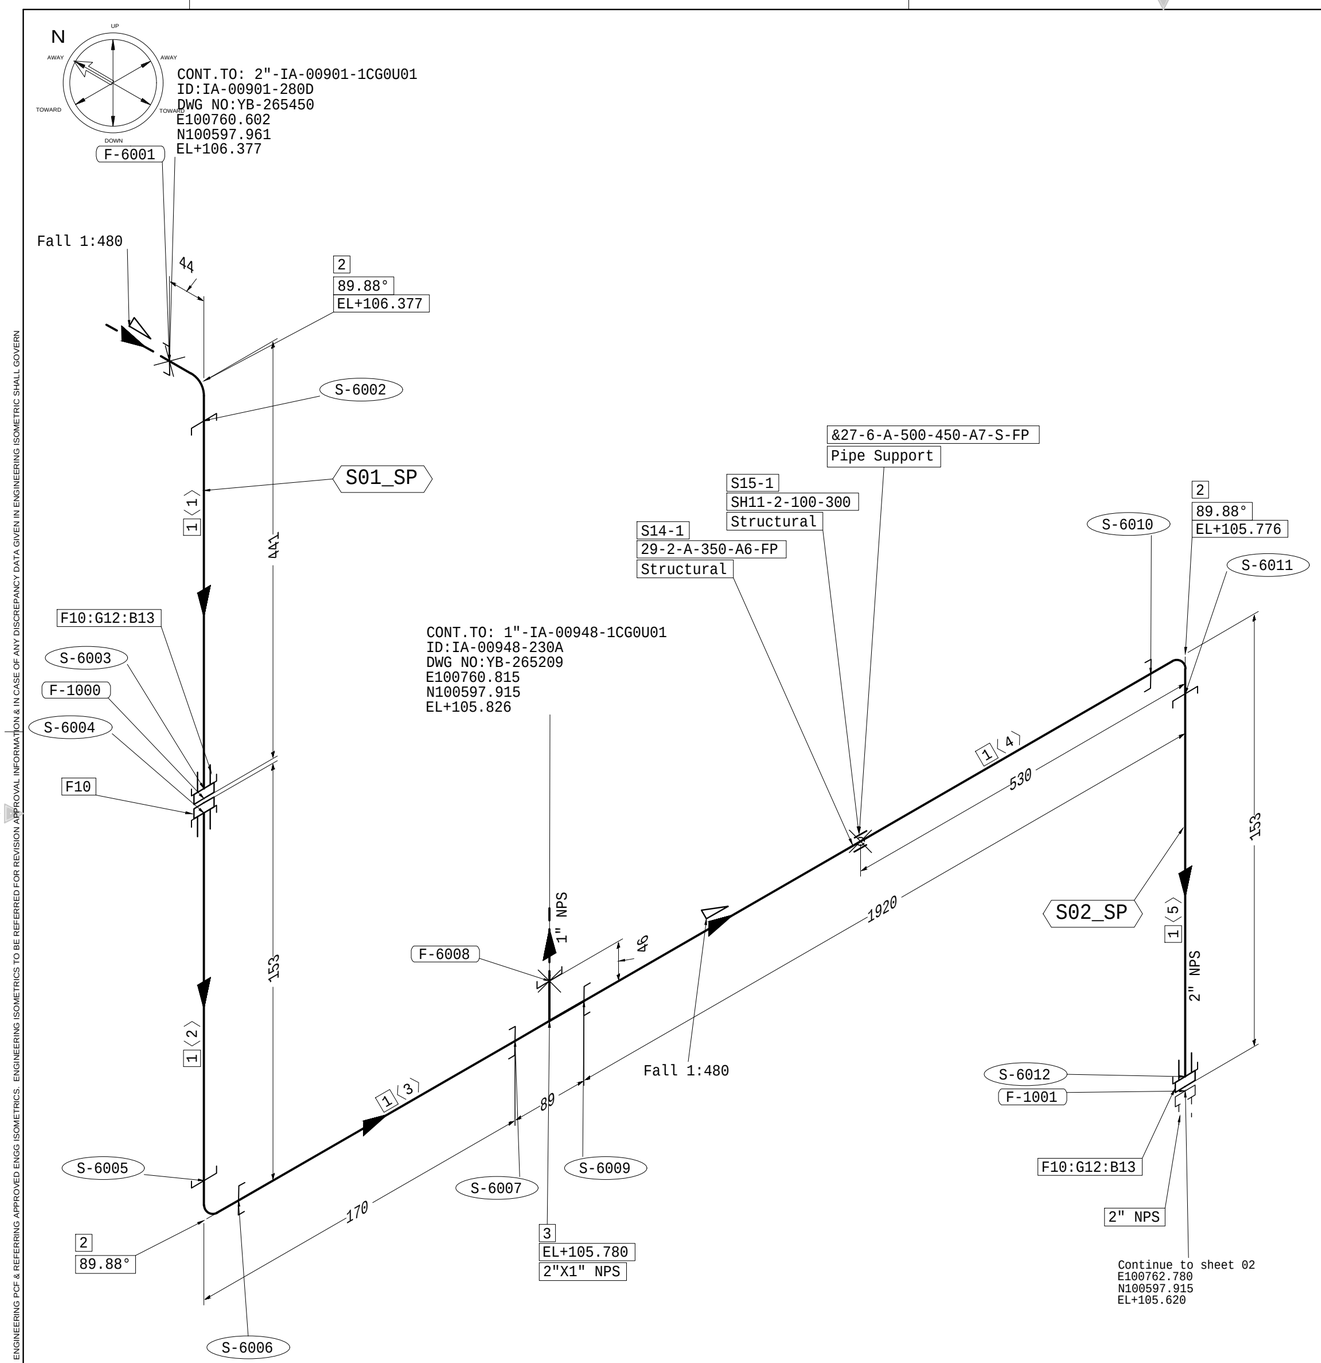

All Pipe attached supports shall be welded before galvanising.

MATERIALS

PT No.	DESCRIPTION	NPD(IN)	ITEM CODE	QTY
	PIPES			
1	PIPE SMLS 2" A106-B GALV STD NPT (M) B36.10M	2	PPS2AEAE02ZZABUAUA	2.615
	FITTINGS			
2	ELB 90° FRG LR 2" A105N GALV 3000# NPT (F) B16.11	2	PE72ADAE02ZZAAOATA	3
3	TEE RED. FRG 2" X 1" A105N GALV 3000# NPT (F) B16.11	2X1	PTR2ADAE0201AAOATA	1
	FLANGES			
10	FLG SCRD RF 2" A105N GALV 150# 125 B16.5	2	PFH2ADAE02ZZAAAADH	3
	GASKET			
12	GSK SPR WND W/CS CENTERING RING + I - SS 2" 4.50 MM THICK SS316L+GRPH FILL 150# B16.20	2	PGUUB5AG02AIAAAZZC	2
	FASTSNERS			
13	BOLT, STUD+2 NUTS A193 B7/ A194 2H, CERAMIC FLP COAT B18.2.1/18.2.2 - 90 mm Length	0.625	PH8AB5AGAF00090ZZF	8
	SUPPORTS			
14	PIPE SUPPORT	2	29-2-A-350-A6-FP	1
15	PIPE SUPPORT	2	SH11-2-100-300	1

PIPE CUT LENGTH SUMMARY

SPL No.	NPD	PC No.	LENGTH	ALLOWANCE	TOTAL LENGTH
S01_SP	2	<1>	0.397	0.000	0.397
S02_SP	2	<5>	0.108	0.000	0.108
S02_SP	2	<4>	1.876	0.000	1.876
S02_SP	2	<3>	0.126	0.000	0.126
S02_SP	2	<2>	0.108	0.000	0.108

SXX_Spool Sequence Number (S01,02...)
SXX_SP - Fab. Spool
SXX_PP - Fab. P to P Doubling (~6M<6M)
SXX_RP - Erec. Random Pipe (6M,12M)
SXX_EP - Erec. Part Loose Fittings
SXX_EF - Erec. Flange (EF-Loose Flange, EFB-Blind, EFS-Spectacle)
SXX_EV - Erec. valve
SXX_EPG - Erec. Pipe Plug
SXX_SBF - Small Bore Spool Fab.
SXX_SBE - Small Bore Spool Erec.
SXX_SBD - Small Bore Spool Drain
SXX_SBV - Small Bore Spool Vent

[X] PART NUMBER
<X> PIECE NUMBER
(SXX) SHOP WELD
(FXX) FIELD WELD
(SXX_01) SPOOL NUMBER

ISO For

NOTES :

1. ALL COORDINATES AND ELEVATIONS ARE IN 'METER' AND ALL DIMENSIONS ARE IN 'MM'.
2. PIPE QUANTITY IS IN METERS AND OTHER QUANTITY IN NUMBERS.
3. FOR STANDARD SUPPORT, REFER DOC. NO. "PP-866-ST-0001".
4. IN CASE OF ANY DISCREPANCY FOR LINE CONDITIONS, LINE DATA GIVEN IN LINE LIST SHALL GOVERN
5. FOR SMALL BORE LINES, DIMENSION & ROUTING SHALL BE FIELD ADJUSTED.
6. THE SPECIFIED THEORETICAL LOCATION OF EQUIPMENT NOZZLES, SUPPORTING STRUCTURE SHALL BE VERIFIED BEFORE INSTALLING THE PIPING & INTOLERABLE DISCREPANCES SHALL BE DISCUSSED WITH DESIGN SITE ENGINEER.
7. ~~ALL THREADED CONNECTION SHALL BE SEAL WELDED, EXCEPT DRAIN AND VENT PLUG.~~
8. REFER LINE LIST.
9. ALL PRESSURE WELDS, OTHER THAN BUTT WELDS,)INCLUDING BRANCH CONNECTIONS SUCH AS BRANCH-OLETS, AND BOSS) SHALL BE 100% PT/MT EXAMINED. ALL ATTACHMENT WELDS ON PRESSURIZED COMPONENTS THAT ARE NOT HYDROTESTED AFTER MAKING THE ATTACHMENT WELD SHALL BE 100% PT/MT EXAMINED.

RLM 001

BUTT WELD · FIELD WELD · INSULATED PIPE · TRACED PIPE · PIPE SUPPORT · PLATFORM PENETRATION · SOCKET WELD · SCREWED JOINT

NOTES CONT. :

91. FOR SOUR SERVICE PWHT IS MANDATORY FOR 1. DOUBLE SIDED WELDING, 2. INTERNAL WELD REPAIR 3. INTERNAL WELD BUILD UP FOR DISSIMILAR THICKNESS JOINTS TO OVERCOME MISALIGNMENT.

PWHT	CHEMICAL CLEANING	PIPING MATERIAL CLASS	DESIGN TEMP. (DEG. F)	DESIGN PRESS. (PSIG)	OPERATING TEMP. (DEG.F)	OPERATING PRESS. (PSIG)	TEST PRESS. (PSIG)	TEST MEDIUM	RADIOGRAPHY % SHOP	RADIOGRAPHY % FIELD	INSULATION THK. (MM)	INSULATION TYPE	TRACING	PAINTING	STRESS SYS NO.	LINE ID
N	NOTE-8	1CG0U01	185	145	135	125	125	SERVICE	NA	NA	0	NI	NA	APCS-26		IA-00901-230A

STANDARD DETAIL REFERENCE DRAWINGS

DETAILS OF HEAVY WELDING BOSSES FOR THREADED CONNECTIONS	AE-036175
CONSTRUCTION DETAILS AND DETAILS FOR ISOMETRIC PIPING	AD-036627
INSULATION DETAILS FOR HOT PIPING	AA-036911
INSULATION DETAILS FOR COLD PIPING	AA-036913
INSTALLATION OF JACK SCREWS FOR FLANGED JOINTS	AC-036630

NOTES

1. MATERIAL SHOWN WITH A BROKEN LINE AND SPOOLS LISTED IN THE SAUDI ARAMCO FABRICATION LIST ARE NOT TO BE FURNISHED BY THE VENDOR.
2. PIPING DETAILS SHALL BE CUT AT ALL POINTS MARKED F.W. (FIELD WELD).
3. EACH FABRICATED SECTION SHALL BE CLEARLY MARKED WITH ITS CODE NUMBER.
4. UNLESS OTHERWISE NOTED. (A) ALL DIMENSIONS ARE TO C/L OR FACE OF FLANGES. (B) BOLT HOLES ON FLANGES STRADDLE C / L. (C) WELDING ELBOWS ARE LONG RADIUS.
5. FABRICATION SHALL BE IN ACCORDANCE WITH SAUDI ARAMCO SPECIFICATION 01-SAMSS-10.
6. GASKET ALLOWANCE _____
7. PIPING MATERIAL IS

PIPE SIZE	SCHEDULE	SPECIFICATION

8. WELDING STRESS RELIEF - YES ☐ NO ☐
   100% X-RAY ☐ SPOT X-RAY 01-SAMSS-10 ☐
9. TESTING SHOP HYDROSTATIC TEST - YES ☐ NO ☐
   THE SHOP HYDROSTATIC TEST SHALL BE CARRIED OUT ON PIECES HAVING ALL ENDS FLANGED. HYDROSTATIC TEST PRESSURE _____
10. ALL PIPING MATERIAL IS IN ACCORDANCE WITH SAUDI ARAMCO ENGINEERING SPECIFICATION SAES-L-105 CLASS _____ . ALL EXCEPTIONS ARE NOTED ON THE ISOMETRIC.
11. INSULATION REQUIRED - YES ☐ NO ☐
    INSULATION SHOWN ON DRAWING _____

SPOOLS TO BE FABRICATED BY VENDOR

NO. PIECES	MARK NO.	SIZE	WEIGHT LBS	NO. PIECES	MARK NO.	SIZE	WEIGHT LBS

SPOOLS TO BE FABRICATED BY SAUDI ARAMCO

NO. PIECES	MARK NO.	SIZE	NO. PIECES	MARK NO.	SIZE

REFERENCE DRAWINGS

PIPING PLAN	
P&ID NO.	YA-221234-001
PLOT PLAN KEY PLAN NO.	TA-293108
INDEX FOR PIPING ISO (AG)	PP-865-LI-0003
INDEX FOR PIPING ISO (UG)	PP-865-LI-0004

REV	DATE	DESCRIPTION	PRPD BY	CHKD BY	APP BY	APP BY
00	29-09-25	ISSUED FOR CONSTRUCTION	AC/SN	KY/PD	BSP	HJ

REVISION STATUS

REVISION VALIDATION

THIS REVISION NO.00 IS COVERED, FOR ALL APPROVAL AND CERTIFICATION REQUIREMENTS, PER SAEP-334, UNDER DRAWING COMPLETION CERTIFICATE NO:
10-14815-0003-000

DESIGN CERTIFICATION (DESIGN AGENCY)		REVIEW FOR KEY DRAWINGS ☐ REQUIRED (SAUDI ARAMCO)		OTHER
ENGG./DATE	CERTIFIED BY/DATE	CONST. AGENCY/DATE	OPERATIONS/DATE	BY/DATE

REV.NO.	DATE	REVISION DESCRIPTION

JOB ORDER/EWO NO: 10-14815-0003

THIS REVISION IS NOT TO BE USED FOR CONSTRUCTION UNTIL CERTIFIED AND DATED

SAUDI ARABIAN OIL COMPANY

ISOM 2"-IA-00901-1CG0U01 — DRAWING TYPE: ISO

IA SERVICE

JFGP GAS PROCESSING TRAIN-2

JAFURAH — SAUDI ARABIA

PLANT NO.	INDEX	DRAWING NUMBER	SHT. NO.	REV. NO.
865	L	YB-265449	01of06	00

SITE REV. NO. 001

RLM-001

RESTRICTED · SMART · CADD-03

450444 21-02-2026

450444 21-04-2026

THIS SPOOL MARKUP DRAWING IS GENERATED FROM ENGINEERING PCF & REFERRING APPROVED ENGG ISOMETRICS. ENGINEERING ISOMETRICS TO BE REFERRED FOR REVISION, APPROVAL INFORMATION & IN CASE OF ANY DISCREPANCY DATA GIVEN IN ENGINEERING ISOMETRIC SHALL GOVERN

THIS DRAWING AND THE INFORMATION CONTAINED HEREIN ARE THE SOLE PROPERTY OF SAUDI ARAMCO. NO REPRODUCTION IN FULL OR IN PART, SHALL BE OBTAINED FROM THIS DRAWING WITHOUT THE WRITTEN CONSENT OF SAUDI ARAMCO.

Saudi Aramco 2025 ENG. (05/25)